SEWER IMPROVEMENT PLANS

GRAMERCY PARK ESTATES

IN

THE VILLAGE OF GAHANNA

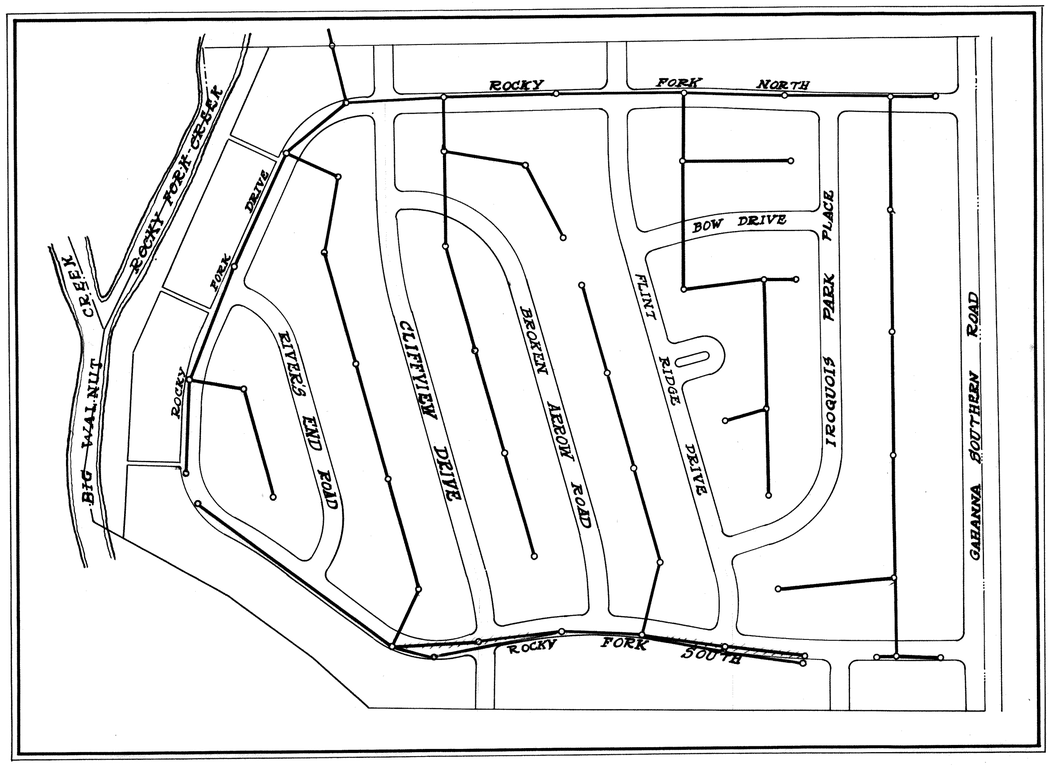

LOCATION PLAN

The General provisions of the Standard Specifications of the Franklin County Sanitary Engineering Department in force at the time of construction shall govern these improvements.

INDEX

TITLE ____ SH. 1
12" Trunk Sewer to Gramercy Park ____ SH. 2
Trunk Sewer - Rocky Fork North ____ SH. 3
East Section ____ SH. 4
Central Section ____ SH. 5
West Section ____ SH. 6

PLAN SCALES
Horiz. 1" = 80'
Vert. 1" = 6'

Submitted this 15TH day of JANUARY, 1954.
by E. G. Evans
Registered Engineer 483

Approved and accepted by Ordinance No. 1-54 passed on this 18th day of January, 1954, by the Council of the Village of Gahanna, Ohio.

William Walters
Village Clerk, Gahanna, Ohio

PLFT'S EX 2-A

Pefts Ex 2A

Revised as Constructed

SA-3½

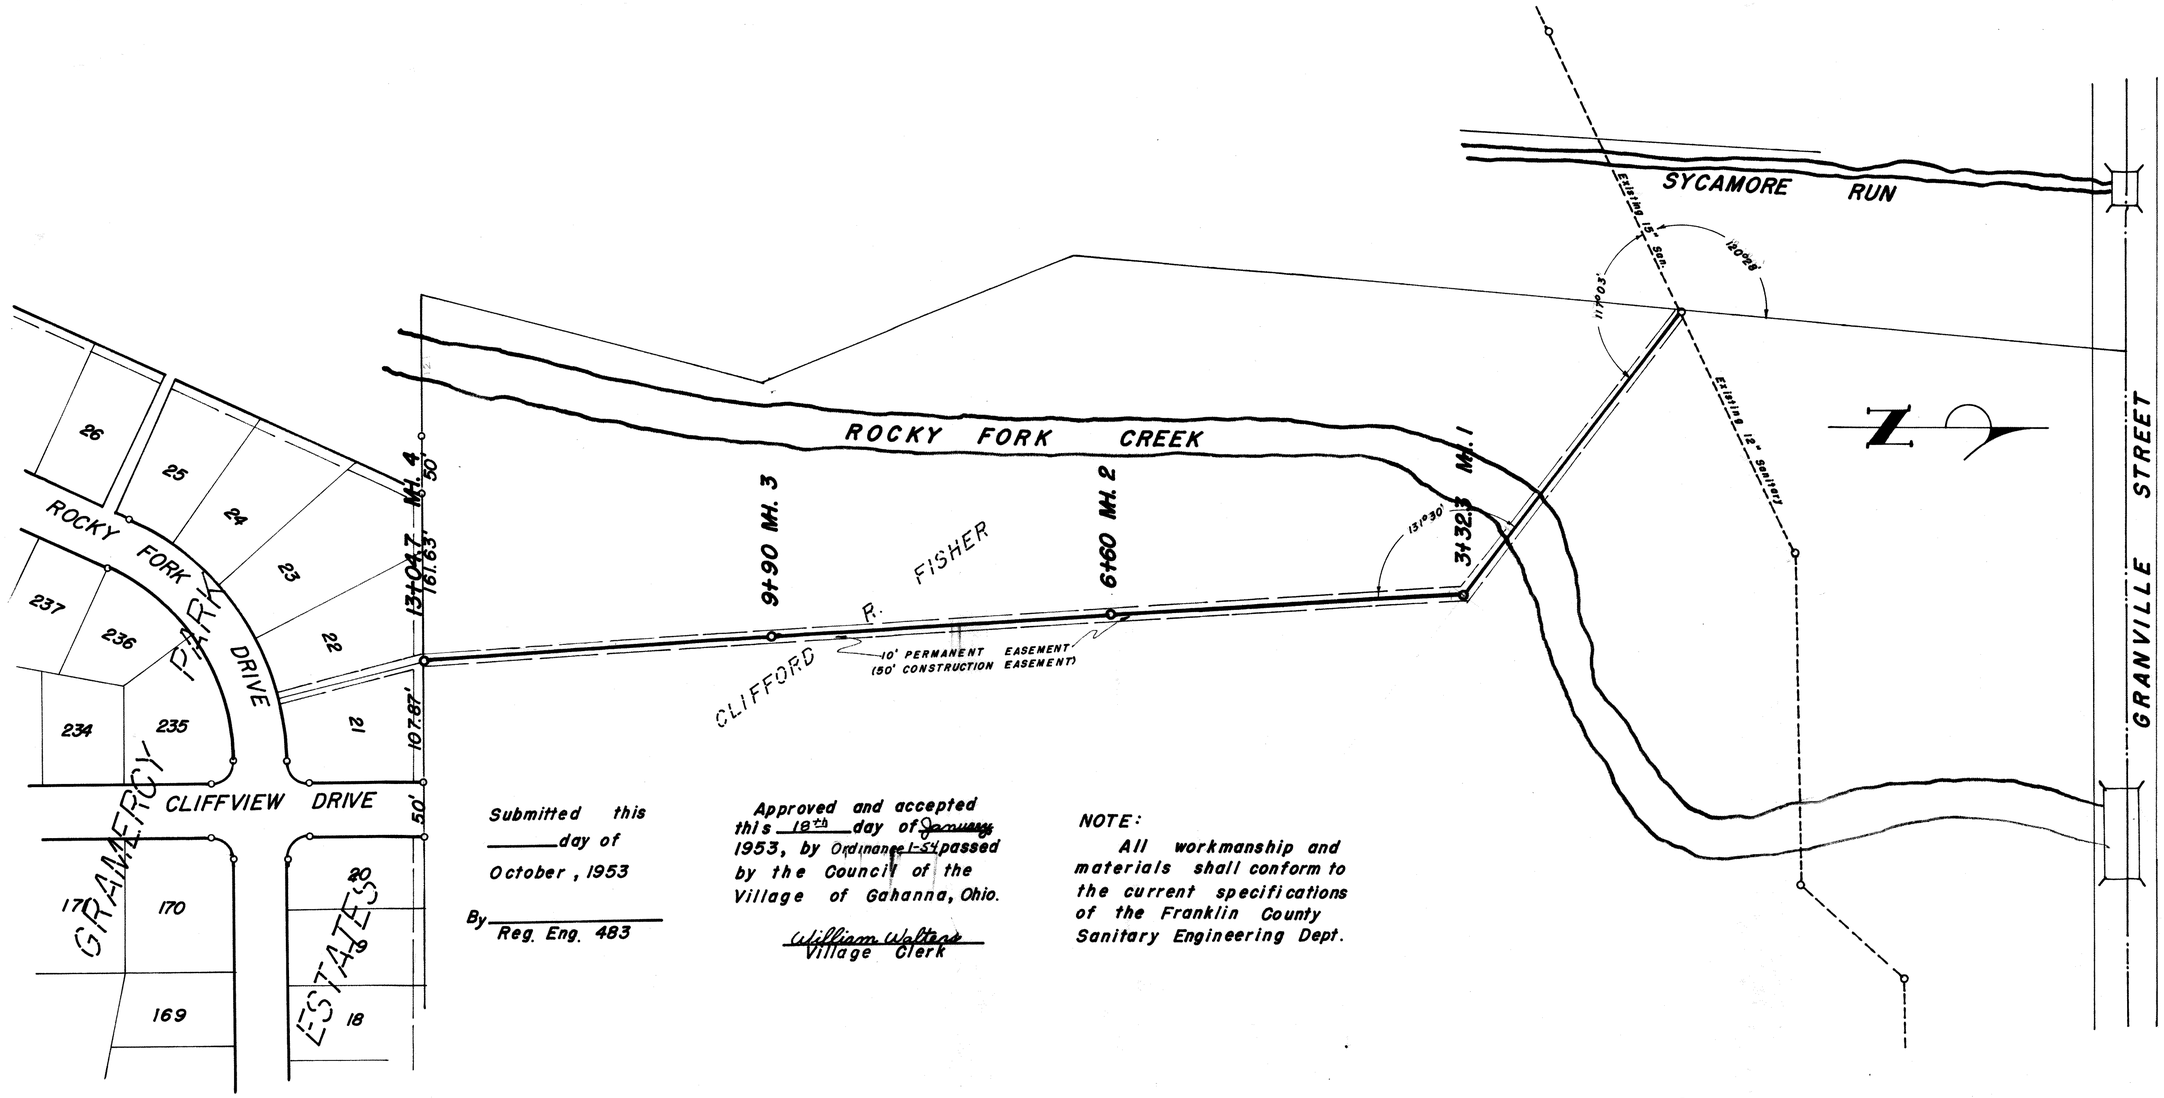

Submitted this
_____ day of
October, 1953

By _____
Reg. Eng. 483

Approved and accepted this 18th day of January 1953, by Ordinance 1-54 passed by the Council of the Village of Gahanna, Ohio.

William Walters
Village Clerk

NOTE:
All workmanship and materials shall conform to the current specifications of the Franklin County Sanitary Engineering Dept.

LEGEND

- Proposed 12" Sewer
- Existing Sewer

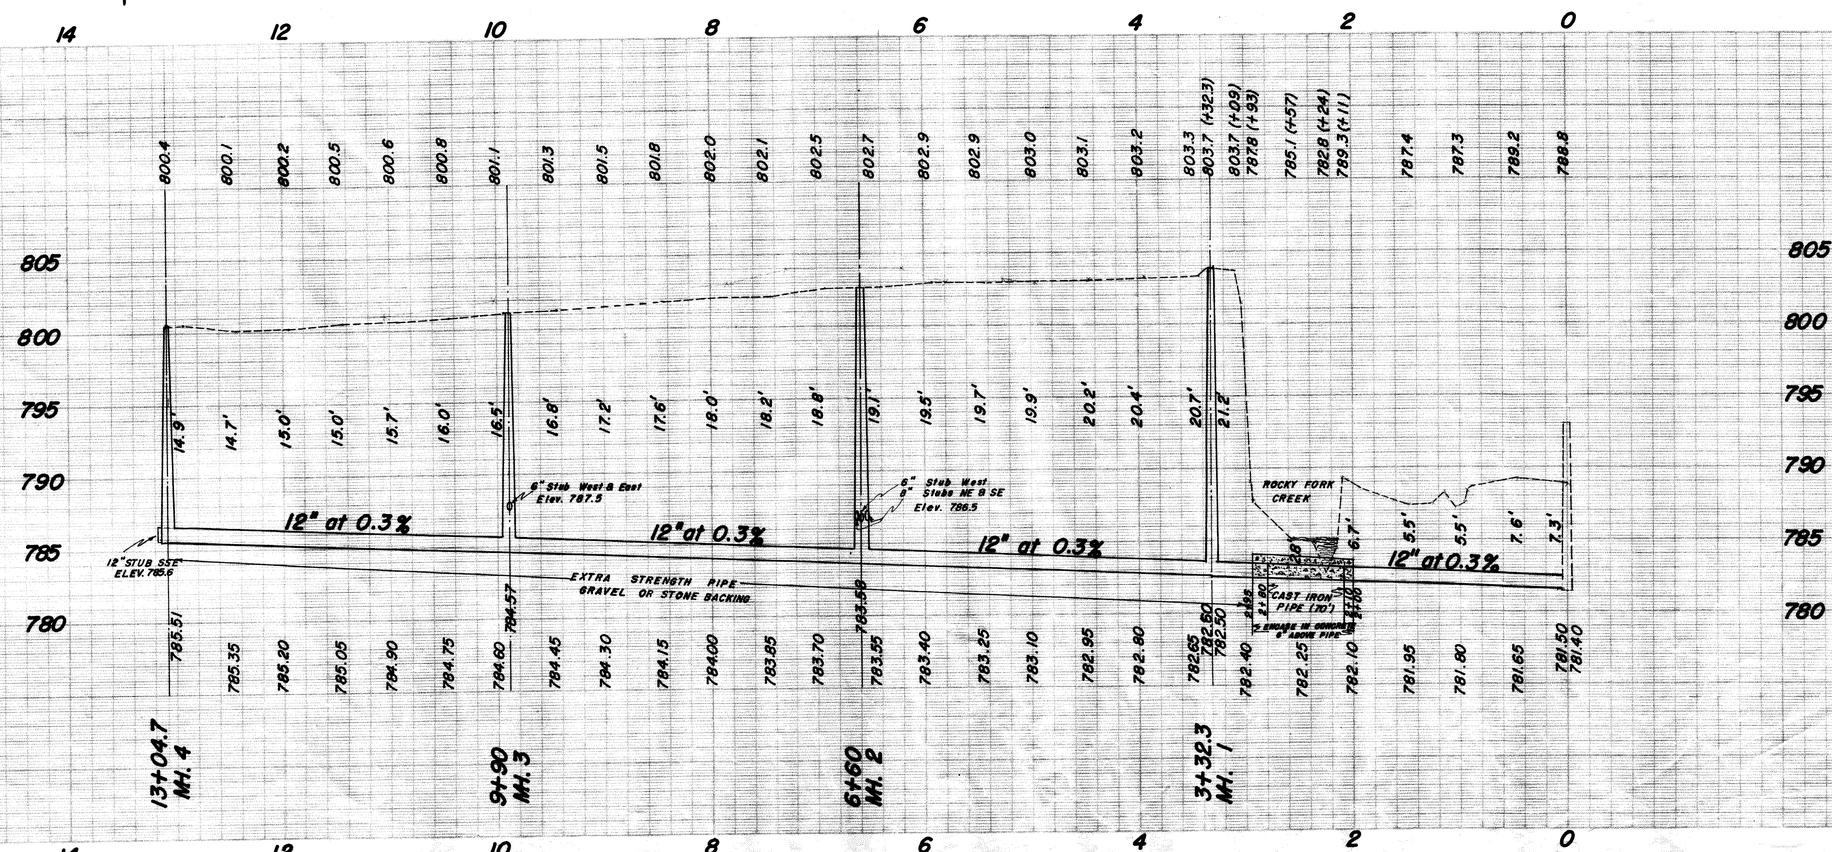

VILLAGE OF GAHANNA
SANITARY SEWER IMPROVEMENT
TO
"GRAMERCY PARK ESTATES"
SCALES Horiz. 1" = 80'
Vert. 1" = 6'
Oct., 1953
by
EVANS & MECHWART
Civil Engineers & Surveyors
Gahanna, Ohio

2B

Revised as Constructed

SA-3%

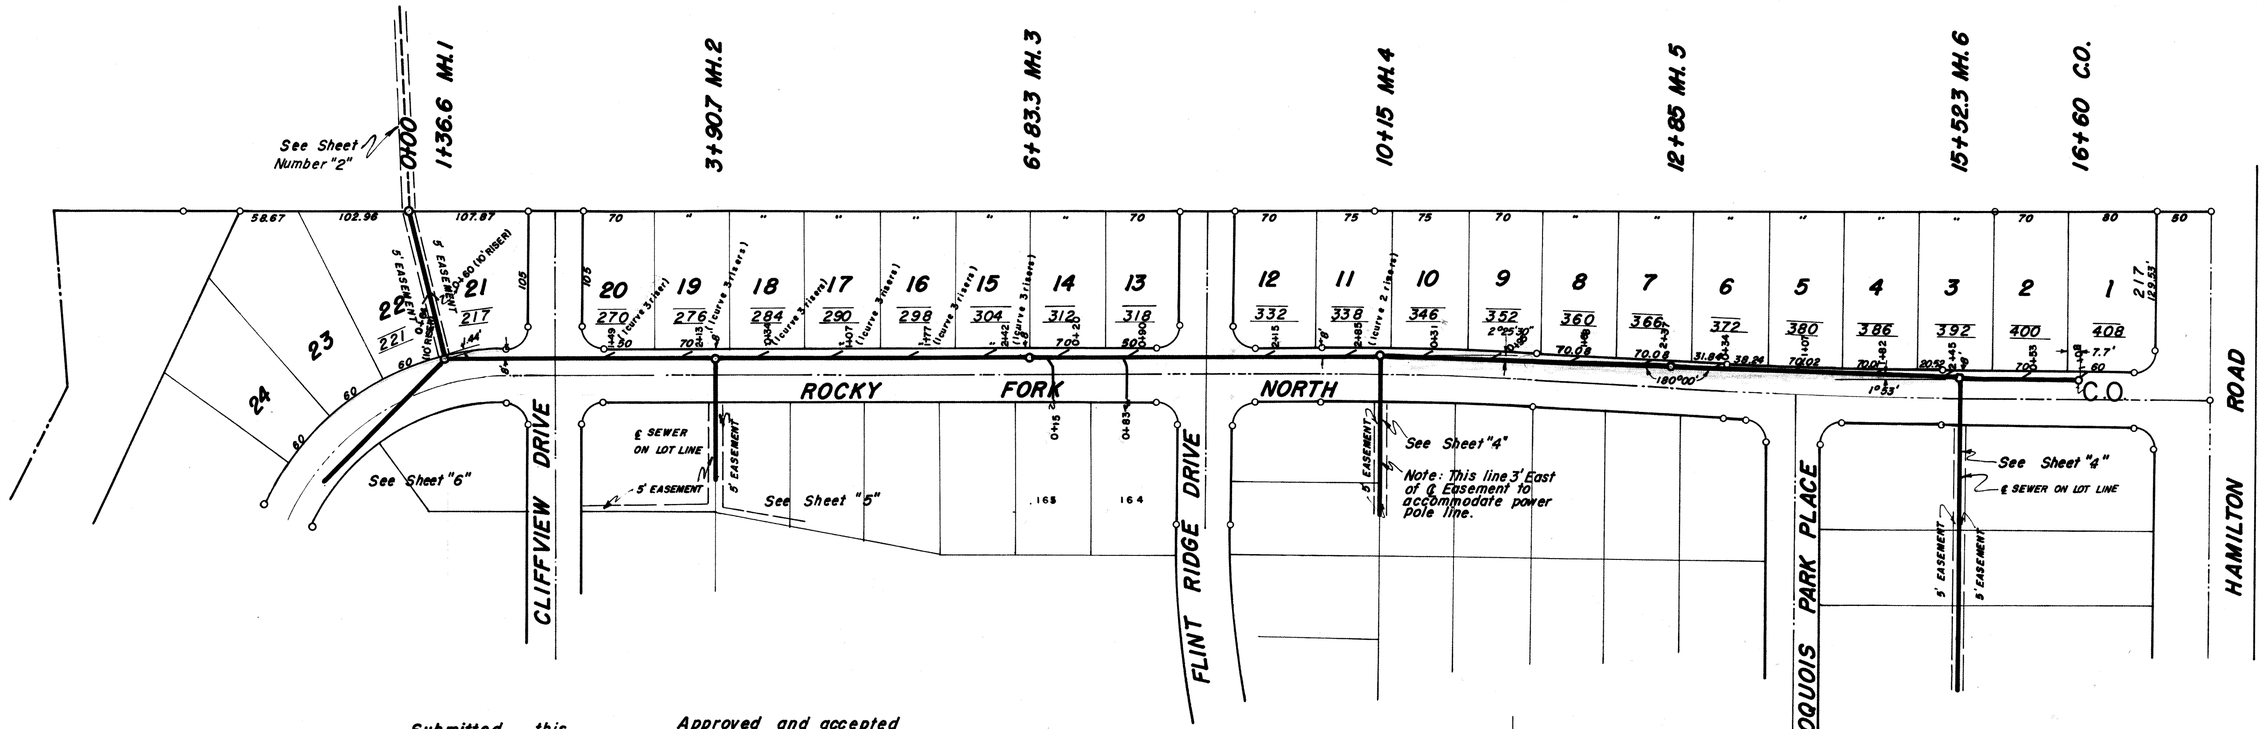

Submitted this _____ day of October, 1953.

By _____
Reg. Eng. 483

Approved and accepted this 18th day of January 195 , by Ordinance 1-54 passed by the Council of the Village of Gahanna, Ohio.

William Walters
Village Clerk

NOTE:
All workmanship and materials shall conform to the current specifications of the Franklin County Sanitary Engineering Dept.

N

Risers shall be placed on all Wyes where depth to flow line is greater than 10 feet.
Top of risers to be 9 feet plus or minus one foot below ground
All service extensions shall be laid at a minimum grade of ¼" per foot unless otherwise ordered.

LEGEND

Proposed Sewers

123 — House Number

2 — Lot Number

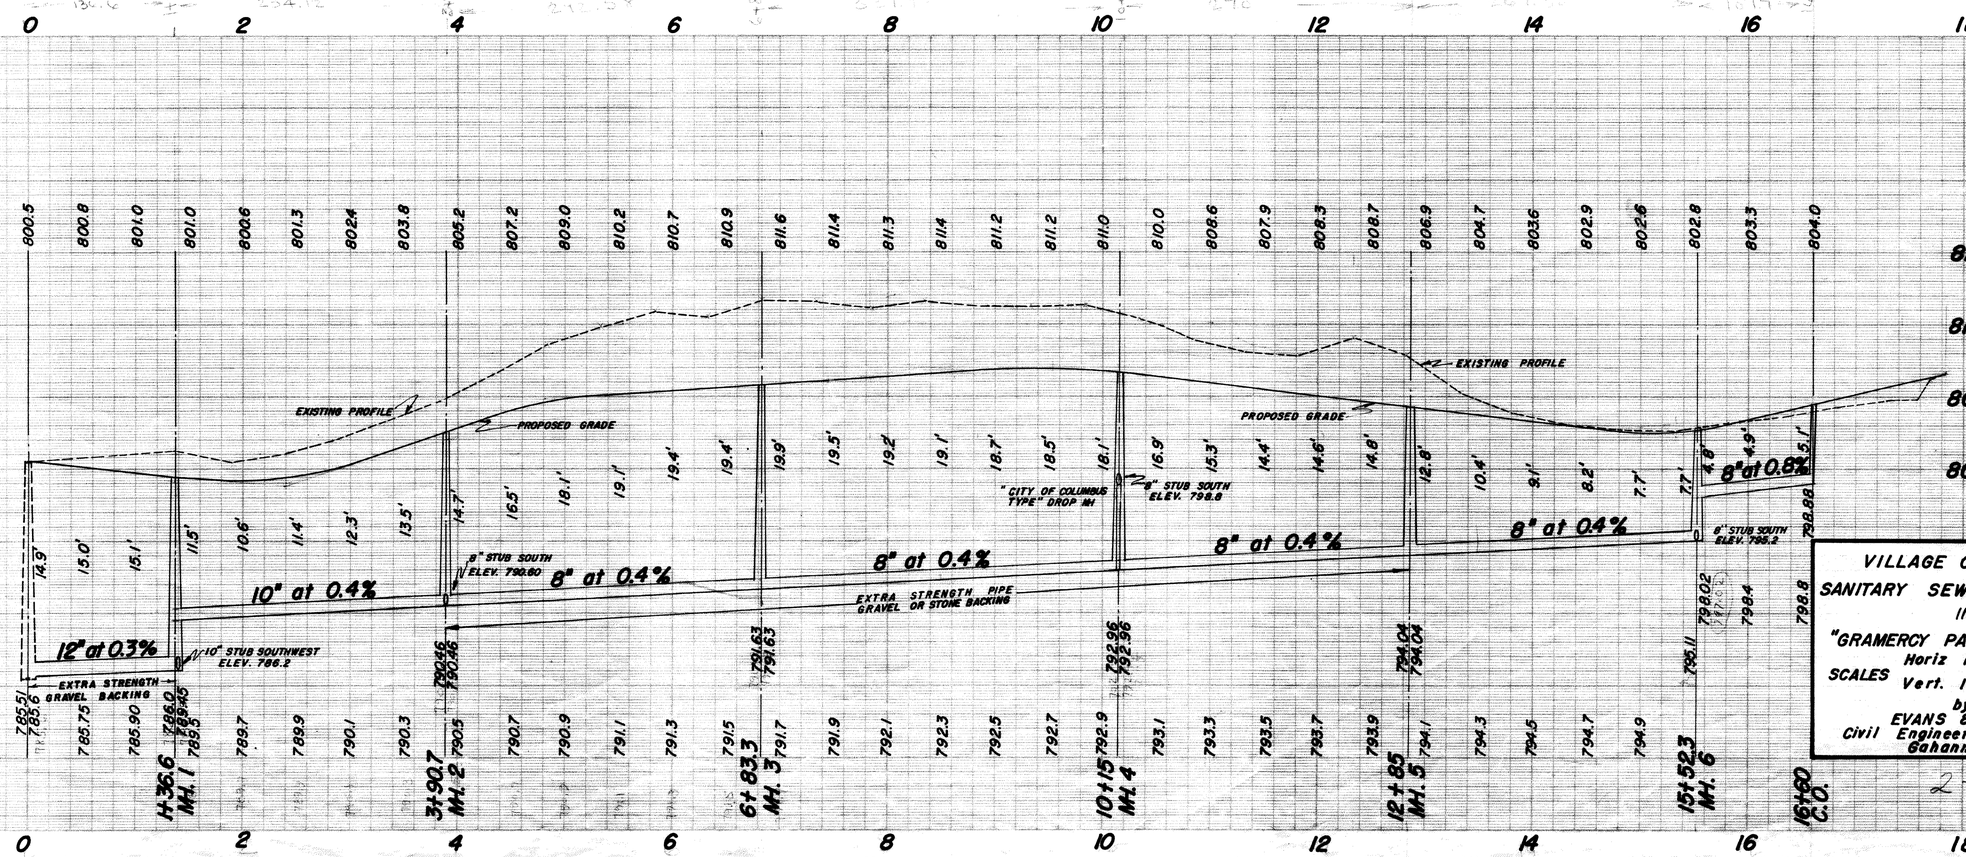

VILLAGE OF GAHANNA
SANITARY SEWER IMPROVEMENT
IN
"GRAMERCY PARK ESTATES"
SCALES Horiz. 1" = 80' Vert. 1" = 6'
Nov., 1953
by
EVANS & MECHWART
Civil Engineers & Surveyors
Gahanna, Ohio

2-C

SA-3 3/6

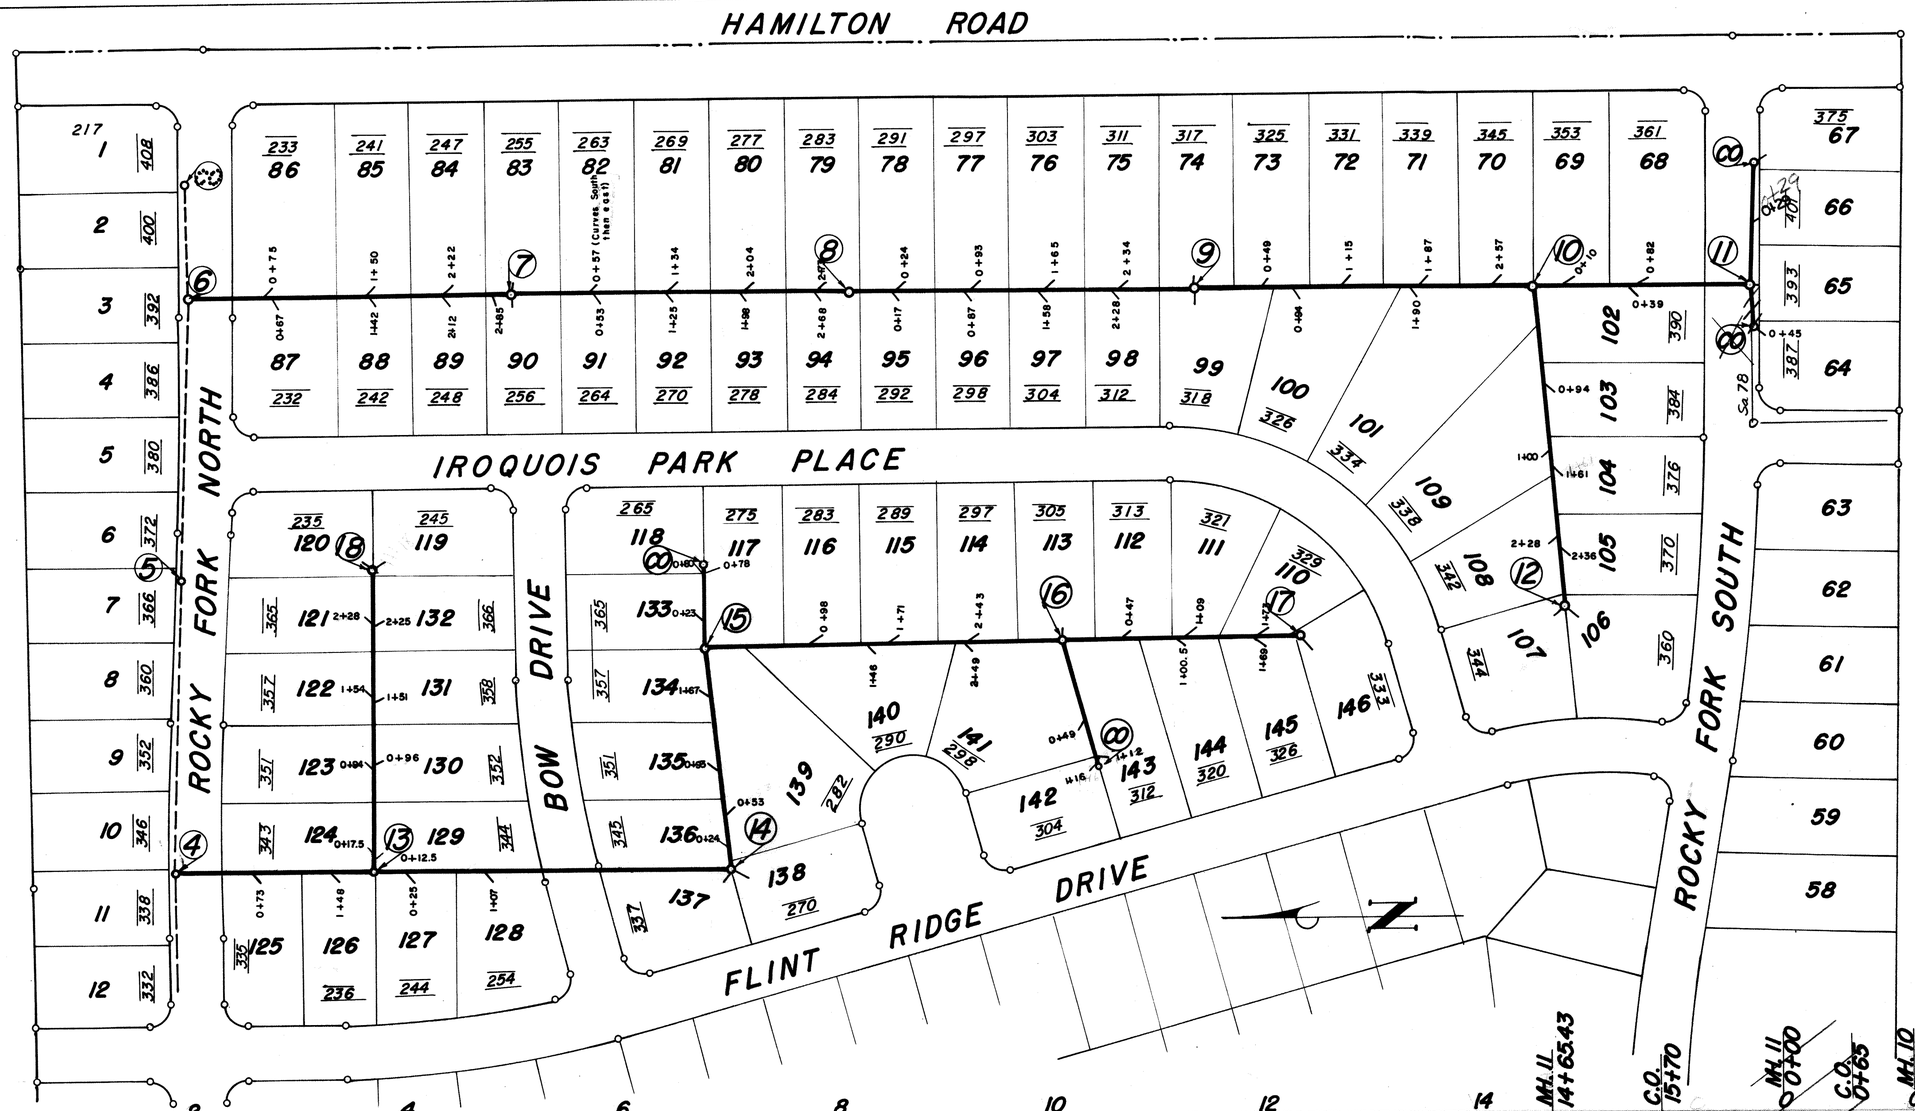

Submitted this 15TH day of JANUARY, 1954.

By G. S. Evans
Registered Engineer 483

Approved and accepted this 18th day of January, 1954, by Ordinance 1-54 passed by the Council of the Village of Gahanna, Ohio

William Walters
Village Clerk

NOTE:

All workmanship and materials shall conform to the current specifications of the Franklin County Sanitary Engineering Dept.

Risers shall be placed on all Wyes where depth to flow line is greater than 10 feet. Top of risers to be 9 feet plus or minus one foot below ground.

All service extensions shall be laid at a minimum grade of ¼" per foot unless otherwise ordered.

Proposed 8" Sewer

123 — House Number

22 — Lot Number

LEGEND

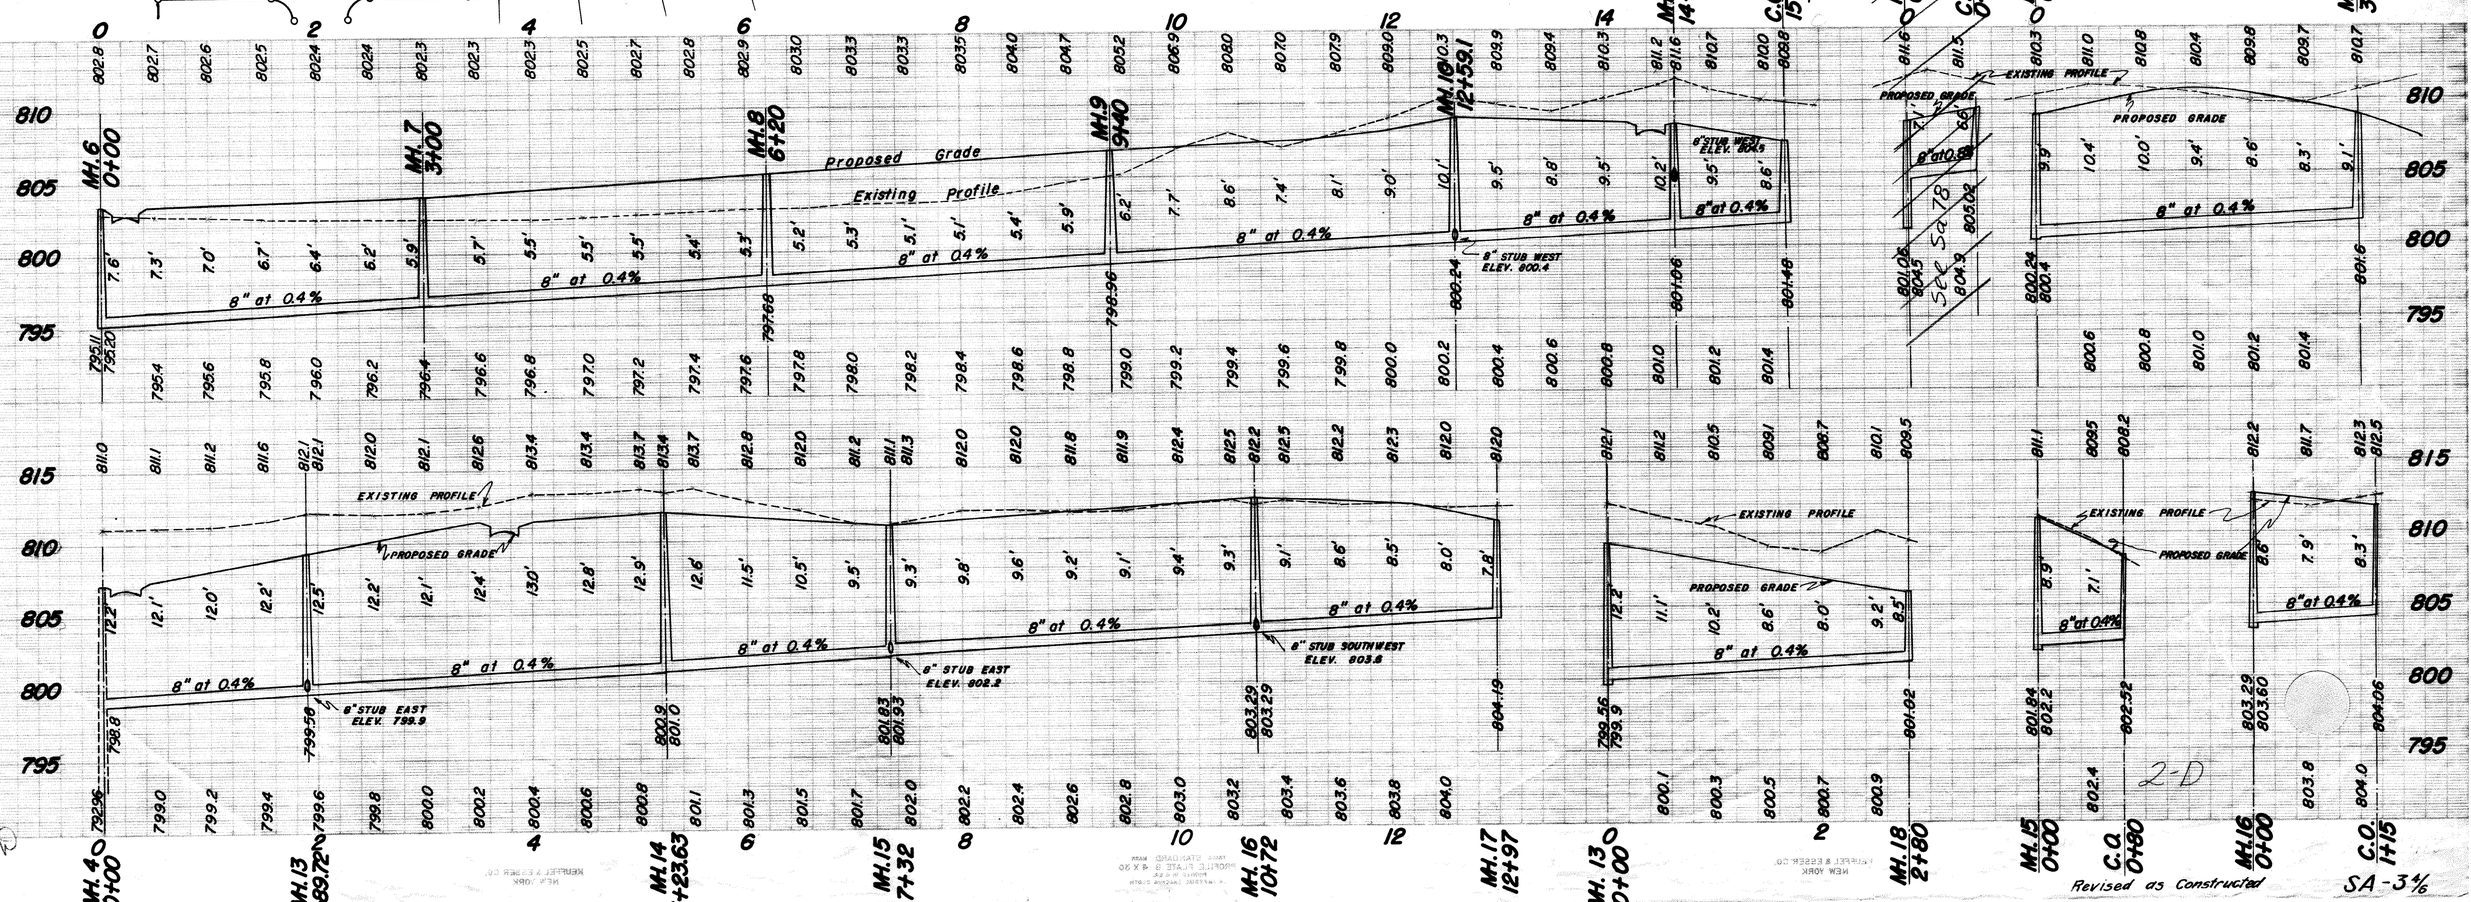

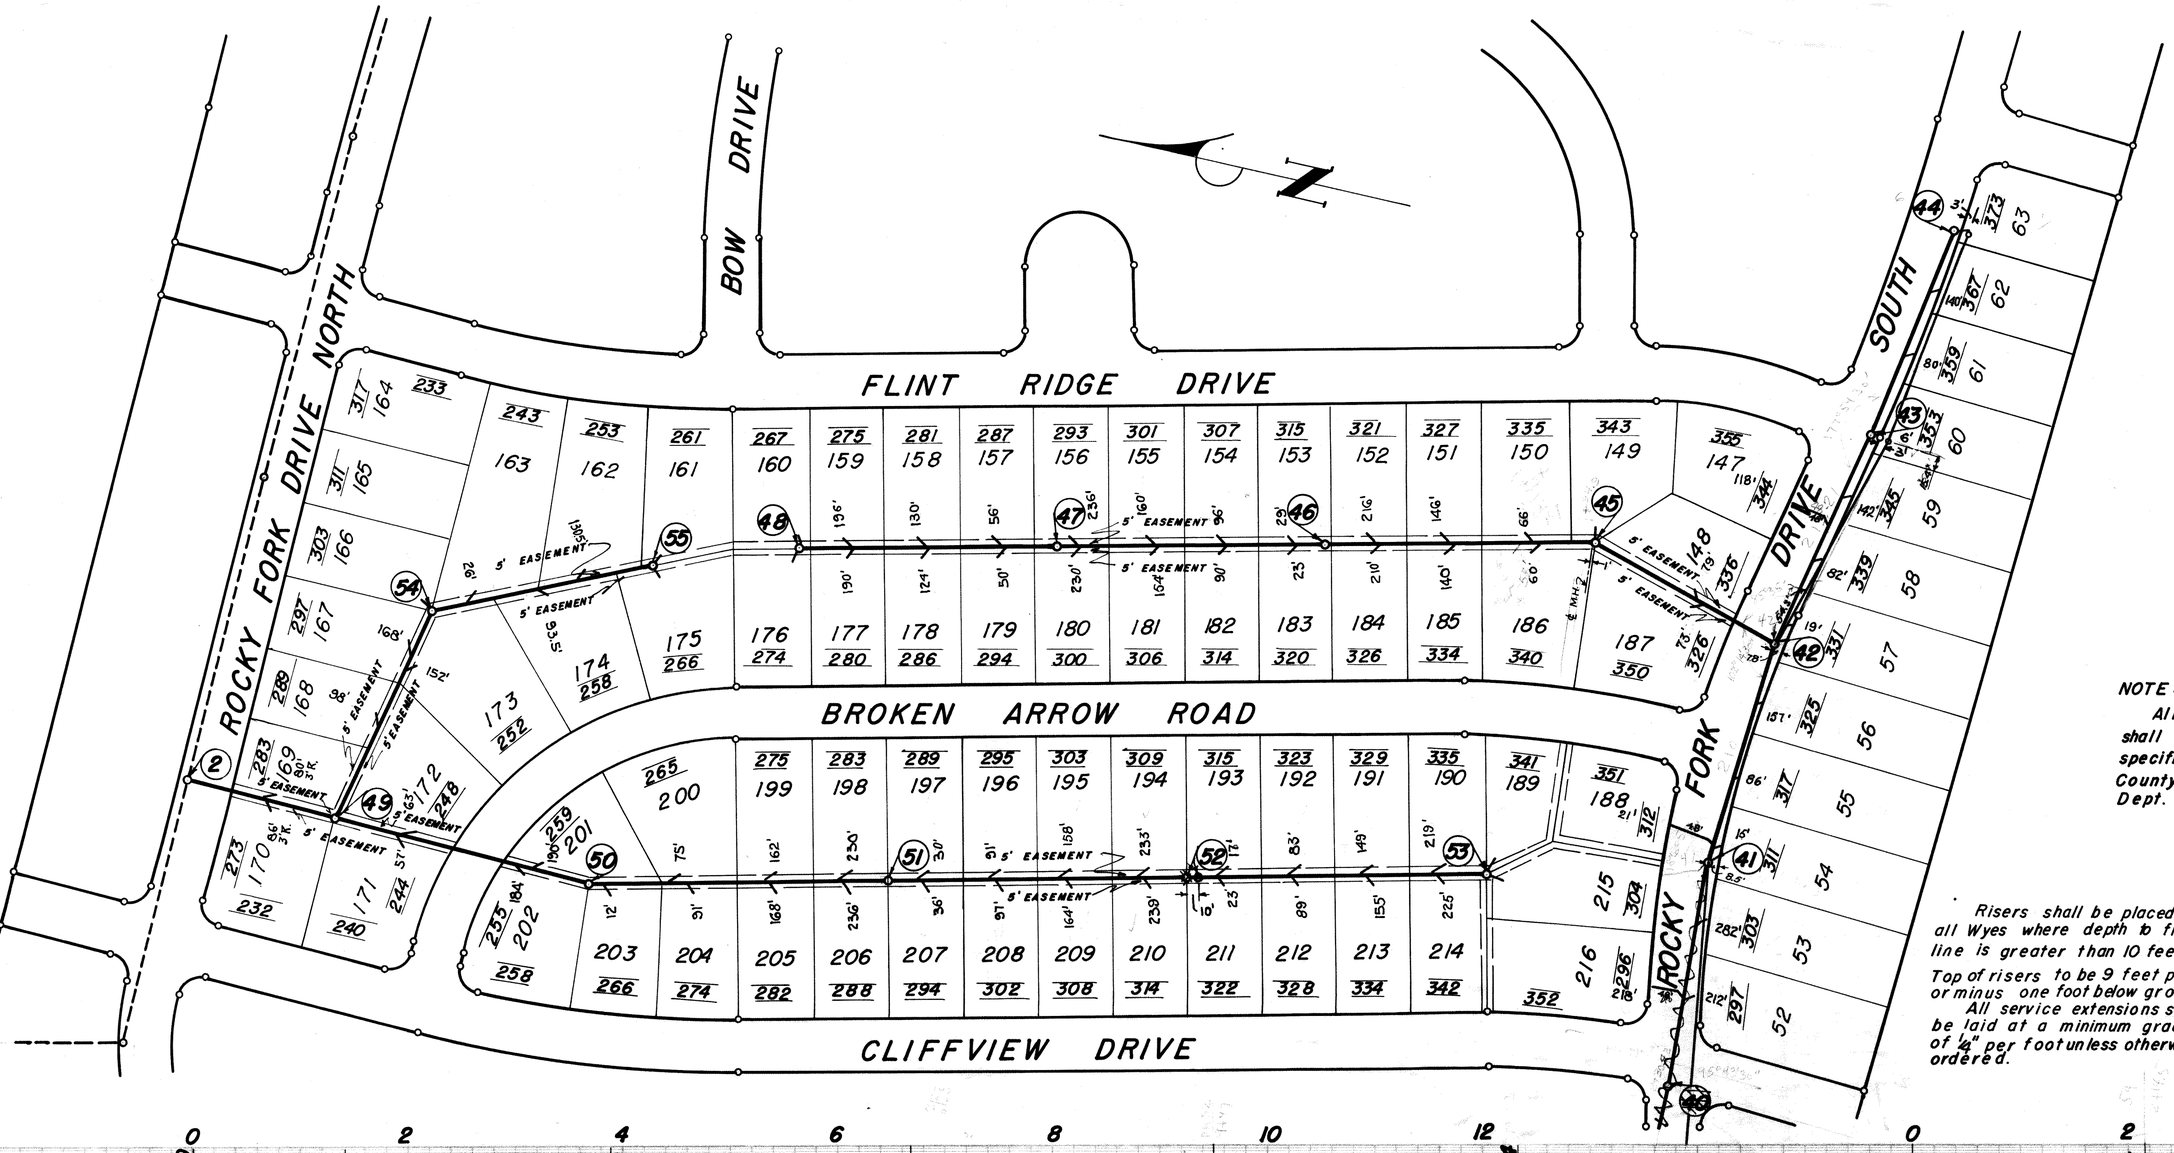

Submitted this 15TH day of JANUARY, 1954.

G. E. Evans
Registered Engineer 483

Approved and accepted this 18th day of January 1954, by Ordinance 1-54 passed by the Council of the Village of Gahanna, Ohio.

William Walters
Village Clerk

NOTE:
All workmanship and materials shall conform to the current specifications of the Franklin County Sanitary Engineering Dept.

Risers shall be placed on all Wyes where depth to flow line is greater than 10 feet
Top of risers to be 9 feet plus or minus one foot below ground.
All service extensions shall be laid at a minimum grade of ¼" per foot unless otherwise ordered.

Proposed Sewer
Existing Sewer

123 House Number
45 Lot Number

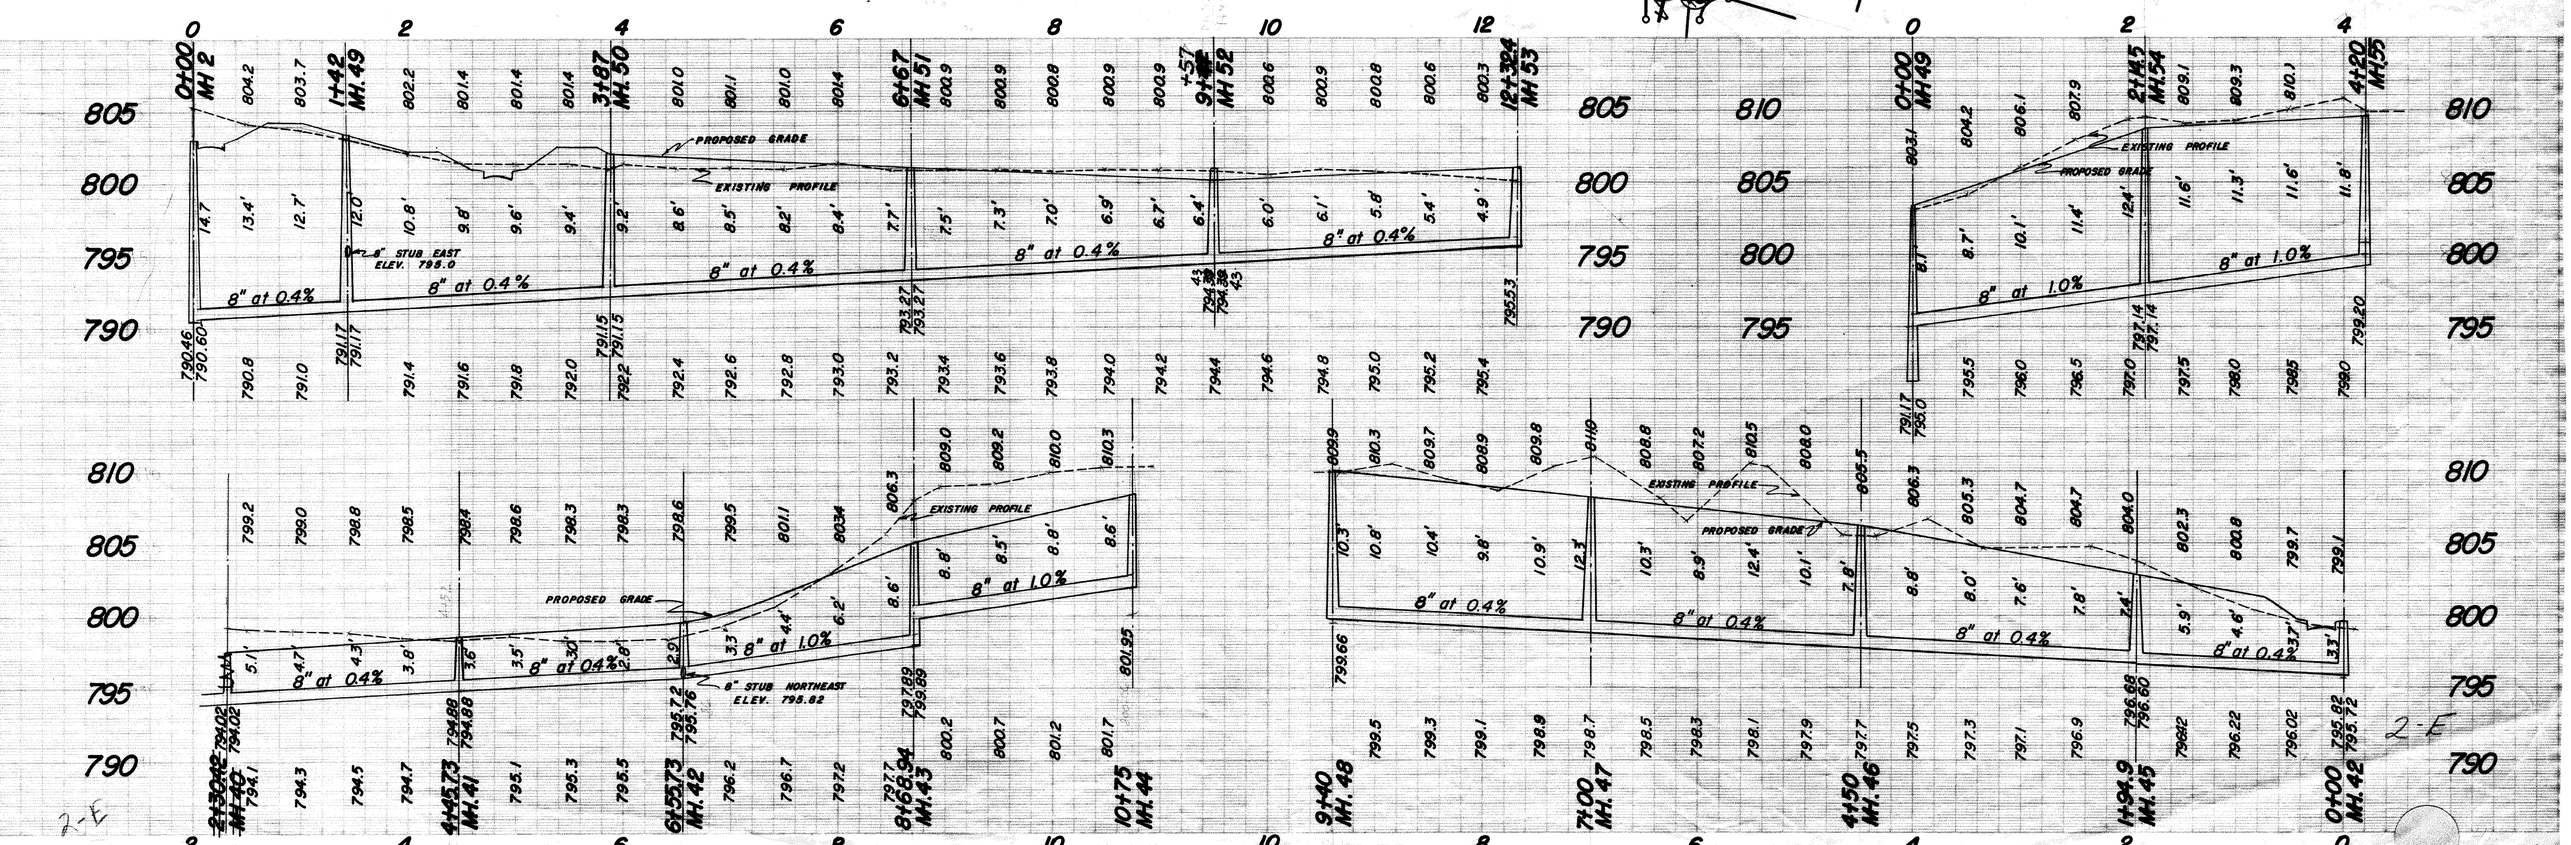

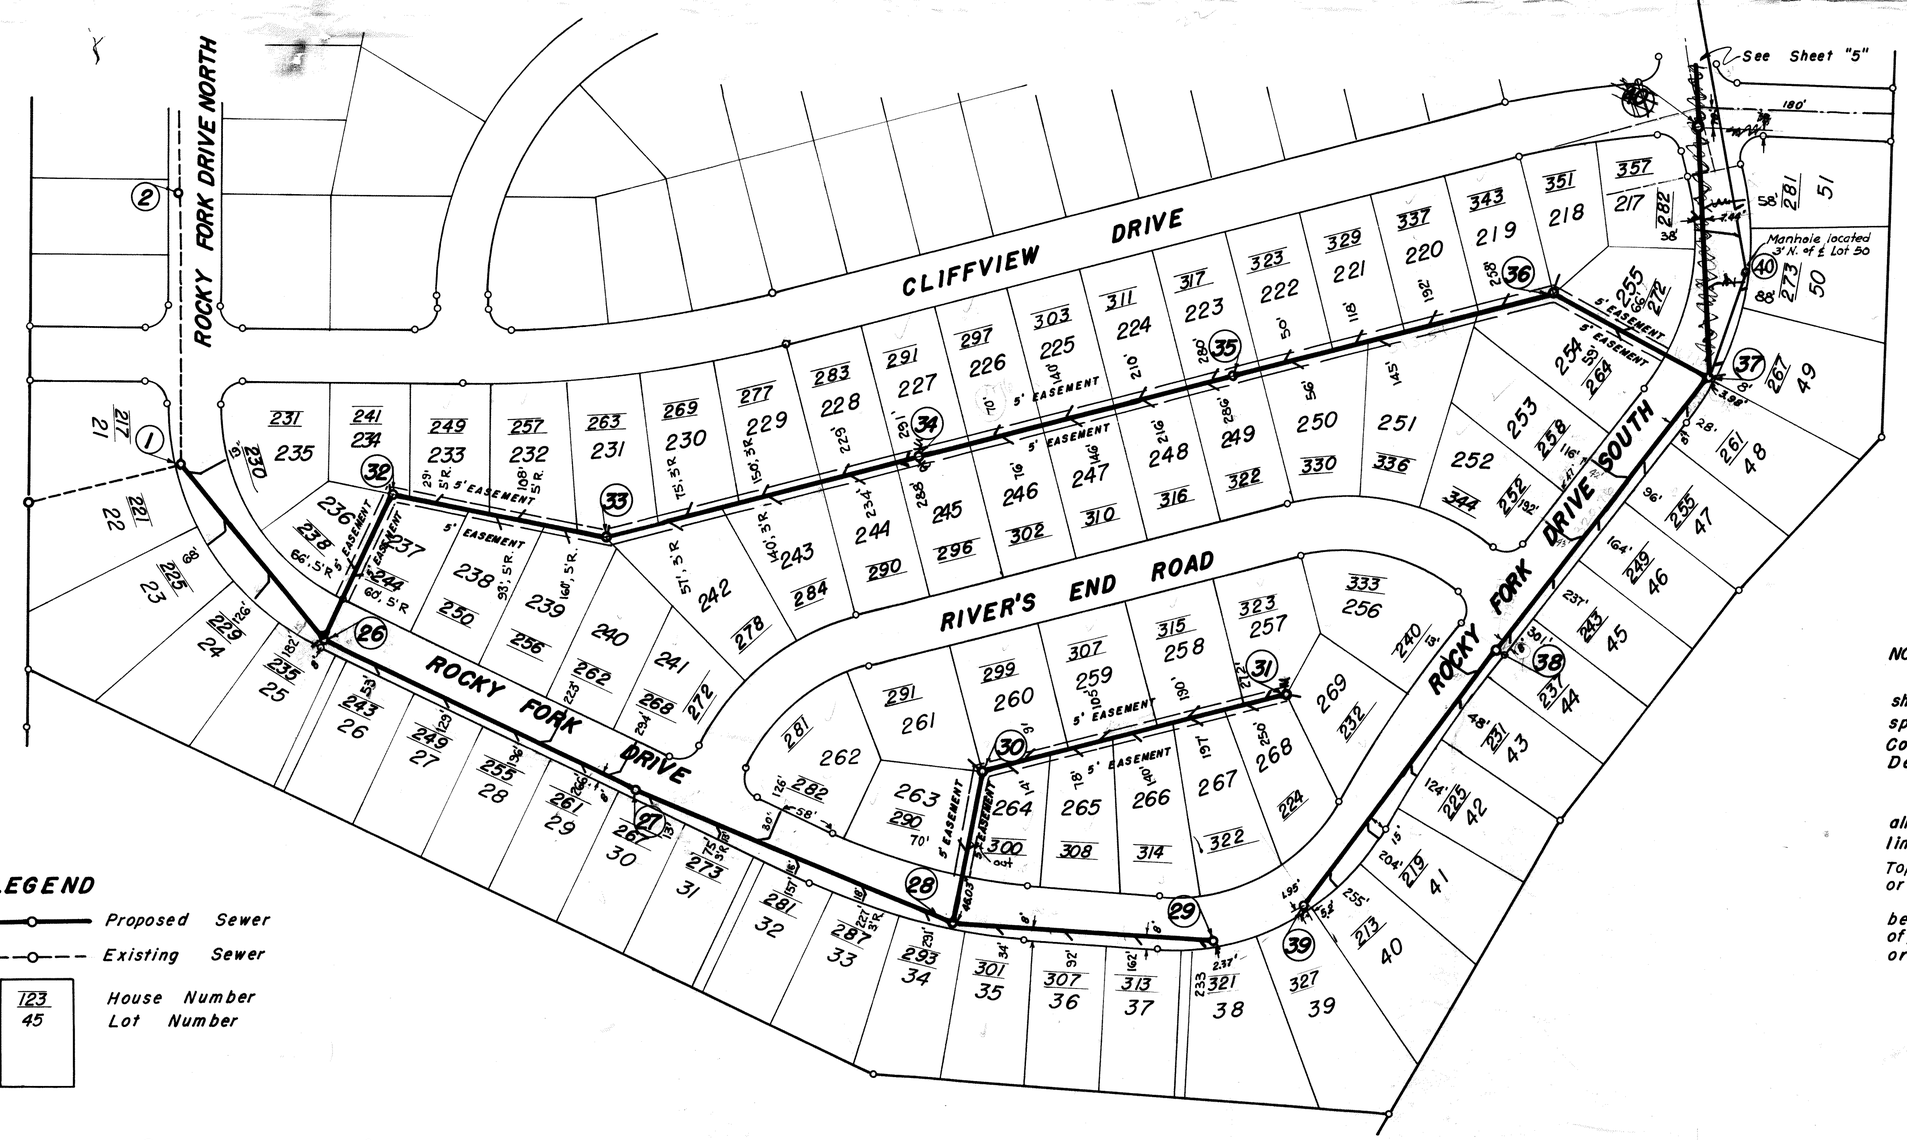

Submitted this 15TH day of JANUARY, 1954.

Registered Engineer 483

Approved and accepted this 18th day of January, 1954, by Ordinance 1-54 passed by the Council of the Village of Gahanna, Ohio.

William Walters
Village Clerk

NOTE:

All workmanship and materials shall conform to the current specifications of the Franklin County Sanitary Engineering Dept.

Risers shall be placed on all Wyes where depth to flow line is greater than 10 feet.

Top of risers to be 9 feet plus or minus one foot below ground.
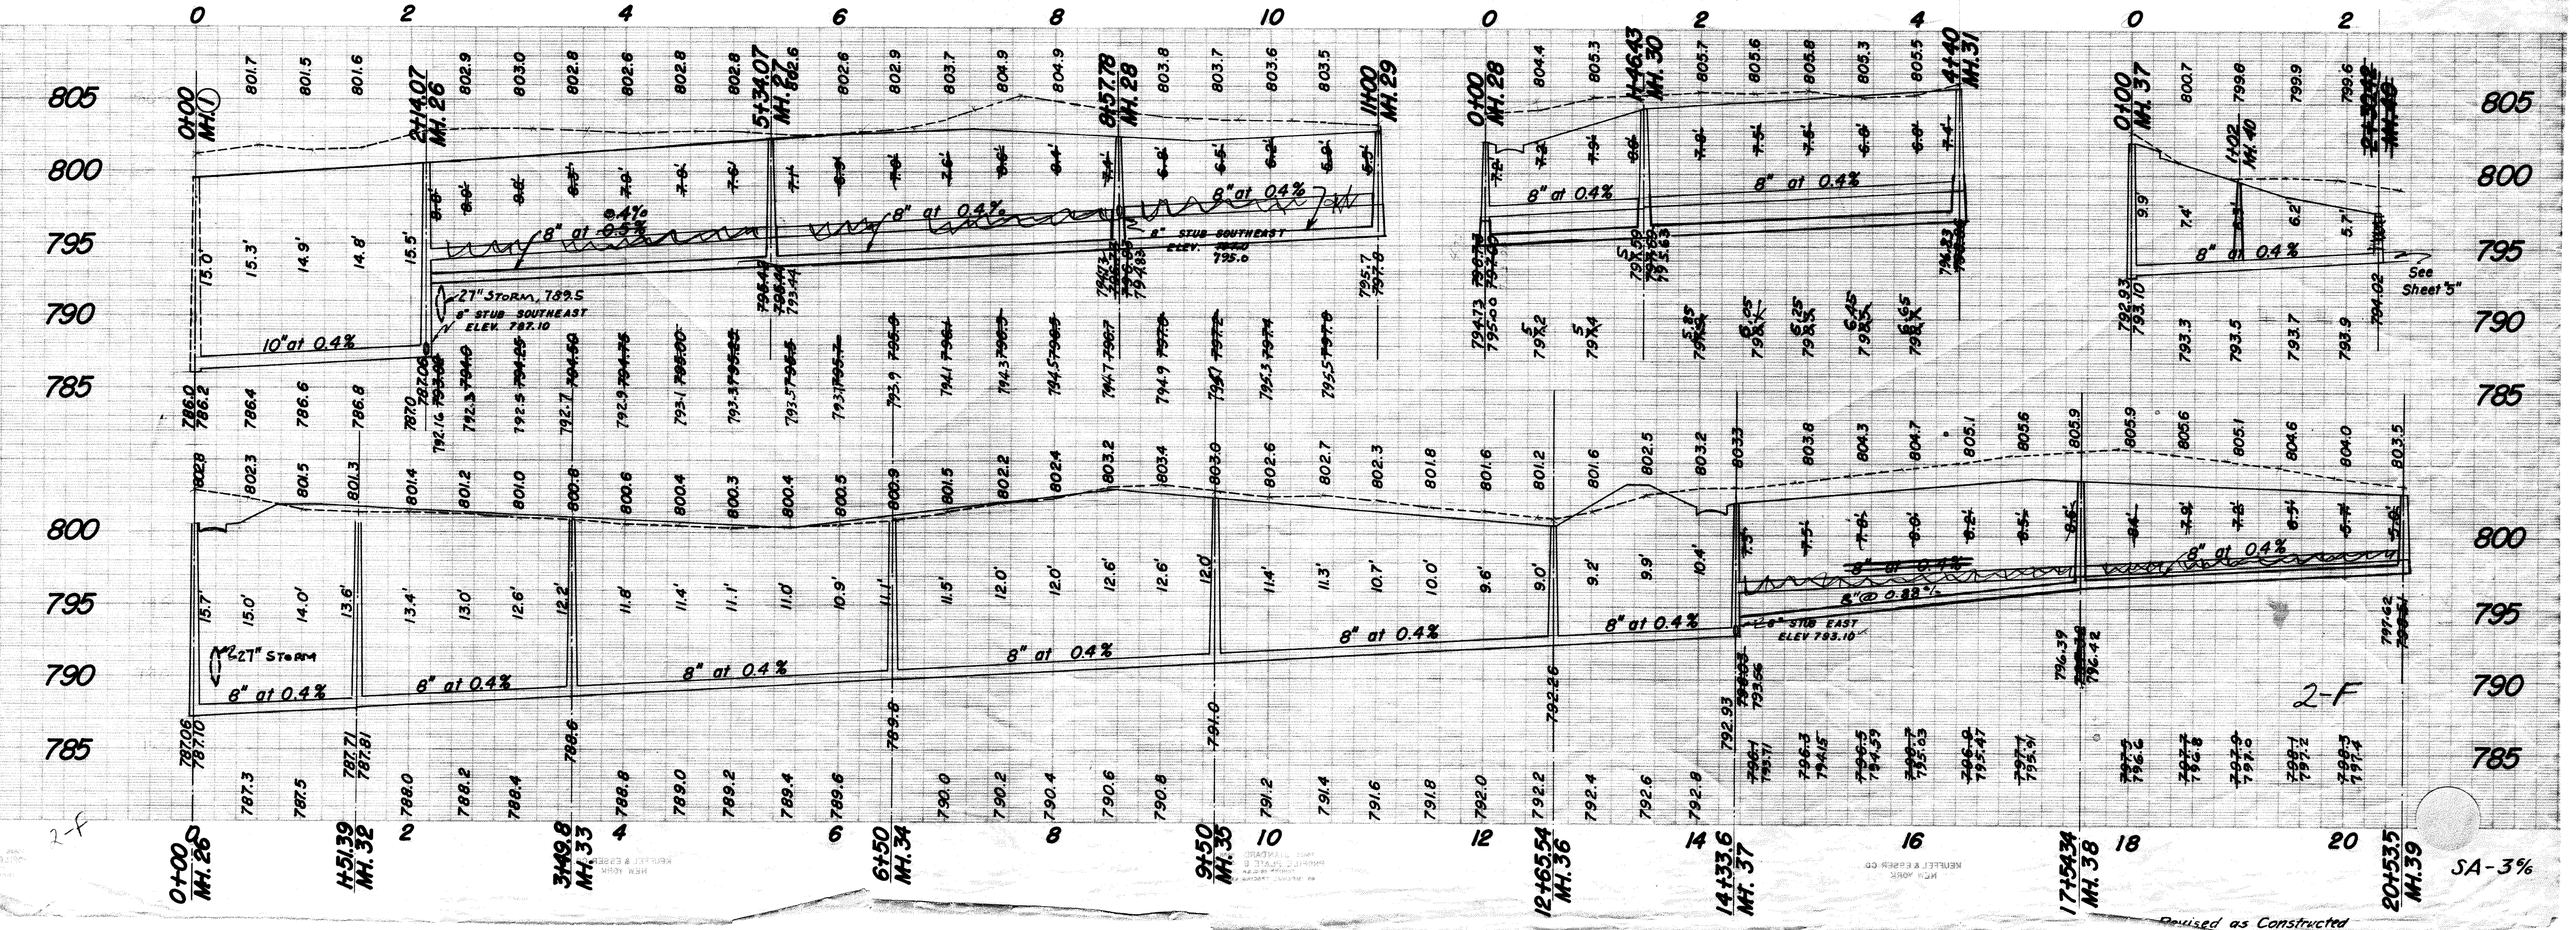
All service extensions shall be laid at a minimum grade of 1/4" per foot unless otherwise ordered.