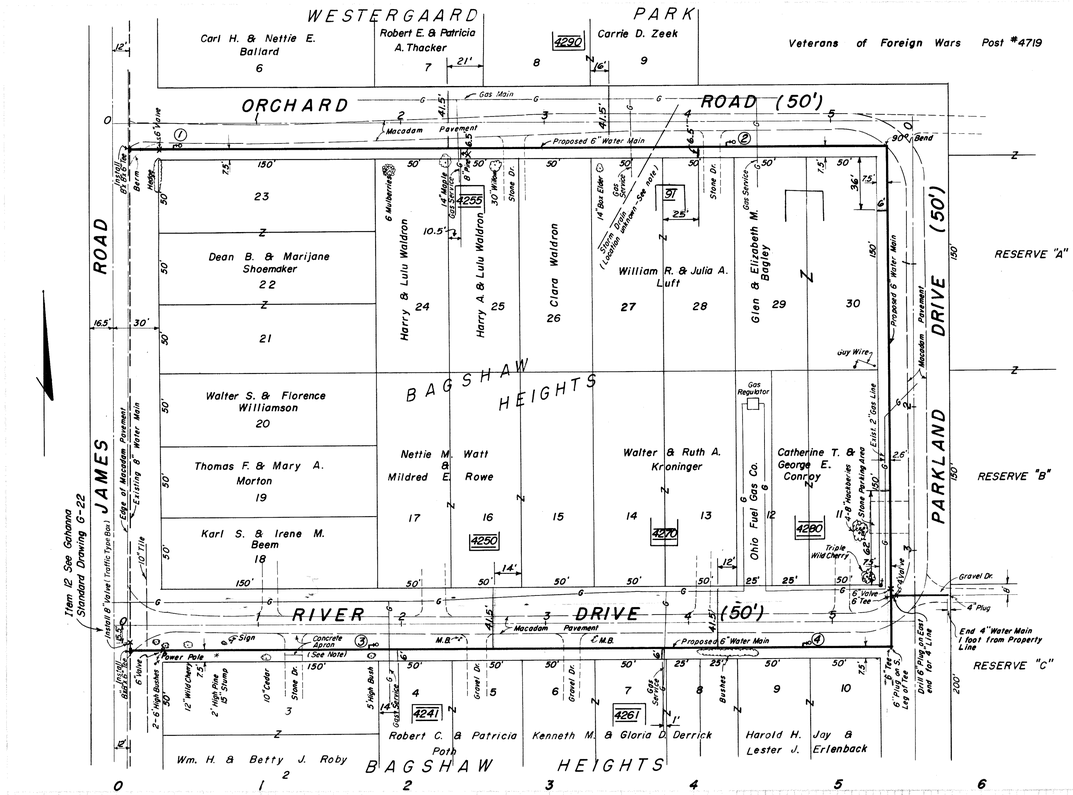

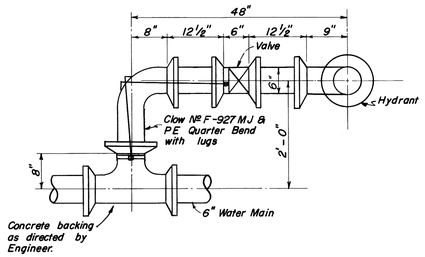

TYPICAL HYDRANT DETAIL

Scale: ¾" = 1'-0"

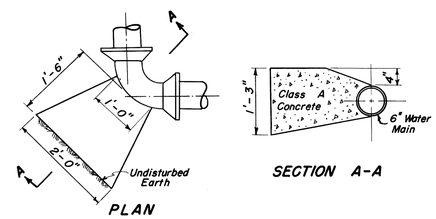

BACKING DETAIL

Scale: ¾" = 1'-0"

Note Re: Storm Drain

If necessary, storm drain shall be replaced as directed by Engineer. Cost of such work shall be included in price bid for the various items of the Contract.

Note Re: Concrete Apron.

The cost of replacement of concrete apron at stone drive for Lot № 3 (S. E. corner of James Rd. and River Dr.) shall be included in the unit price bid per lineal foot of Water Main.

Jefferson Local
School District
Recreation Council

B. M. – Spike in Power Pole #28A75 at S.E. corner James Rd. and River Dr. Elev. 803.21

PLANS PREPARED BY
EVANS MECHWART HAMBLETON & TILTON
VILLAGE ENGINEER
GAHANNA, OHIO

By John S. Tilton
Registered Engineer

Approved this 1st day of August, 1960 — Phelps S. Wescoll, Mayor, Village of Gahanna, Ohio

Approved this 1st day of August, 1960 — William Watters, Clerk, Village of Gahanna, Ohio

Approved this 8th day of August, 1960 — Norman H. Pagan, President, Board of Trustees of Public Affairs

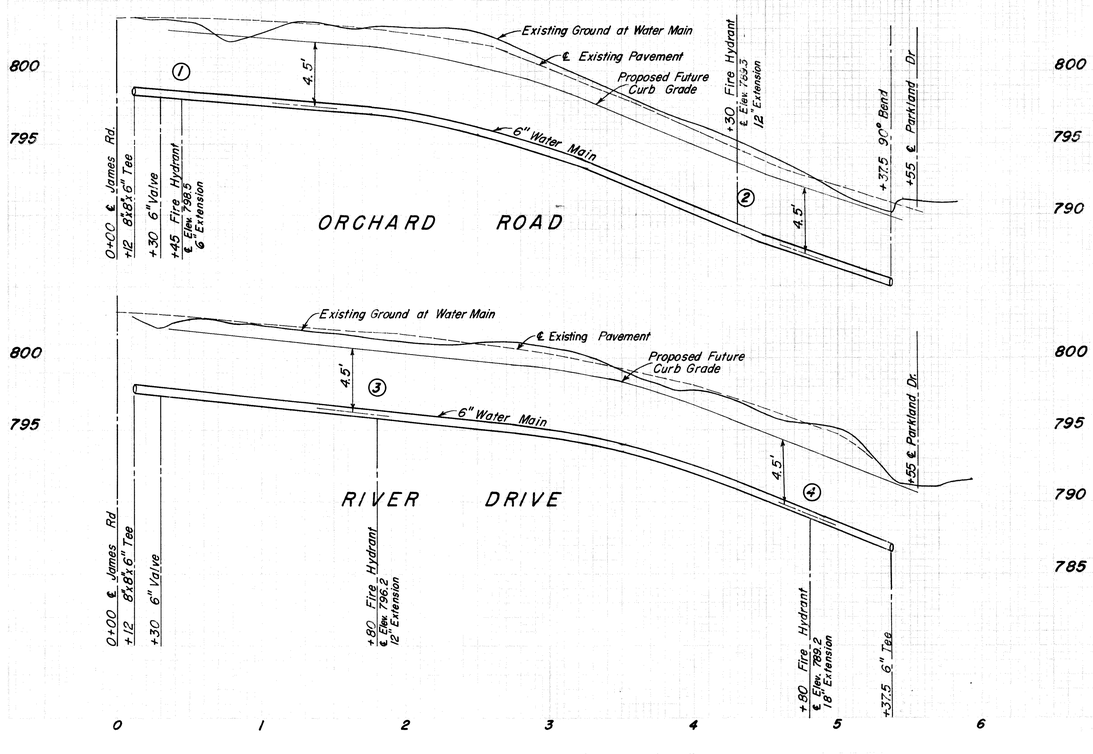

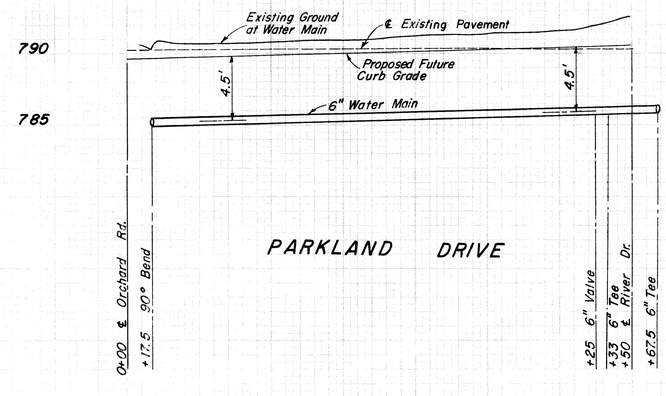

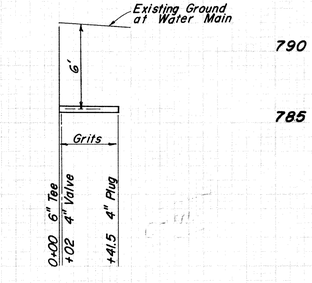

PROFILE OF 4" WATER LINE

COUNTY OF FRANKLIN
VILLAGE OF GAHANNA, OHIO

WATER IMPROVEMENT CONTRACT №2-60

6 INCH WATER LINE IN ORCHARD ROAD - FROM JAMES RD. TO PARKLAND DR. - RIVER DRIVE - FROM JAMES RD. TO PARKLAND DR. - PARKLAND DRIVE - FROM ORCHARD RD. TO RIVER DR.

SCALE: HORIZ. 1" = 50' VERT. 1" = 5'

JULY, 1960

Revised as Constructed Dec. 1960

Wa - 57